

# 4 Feedthroughs

# TM OSEMs

TM OSEM to BF Cable  
JGW-D1503901 Sheet 01

Type 5-2.2 (BS) or -1.7 (SR)

BF to F0 Signal Cable  
JGW-D1503901 Sheet 08

Type 3-4

PI-Flange Signal Cable  
JGW\_D1503901 Sheet 11










Type 1

Feedthrough









Anti-Feedthrough Adapter Cable

OSEM External Cable









Sat Amp #0  
D1402809

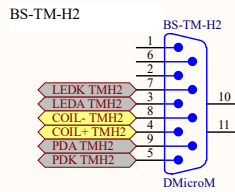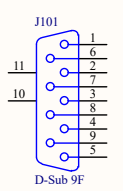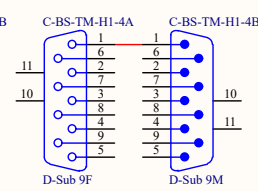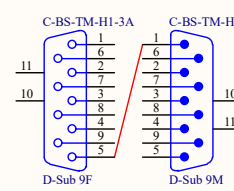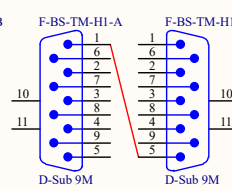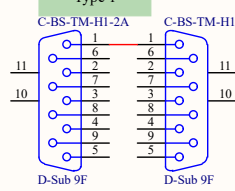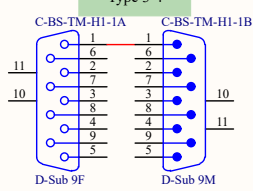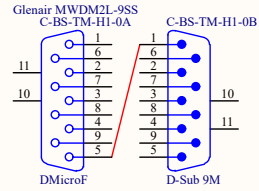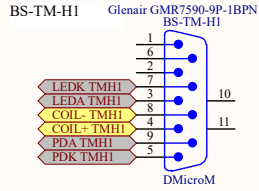









Type 5-2.4 (BS) or -2 (SR)

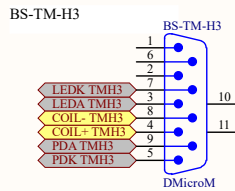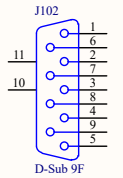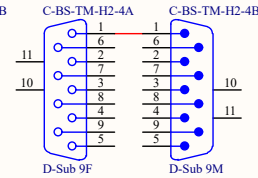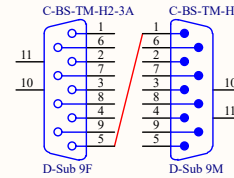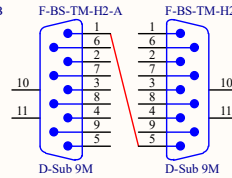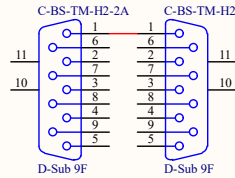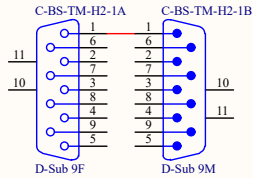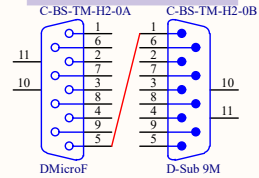

Type 5-2.4 (BS) or -2 (SR)

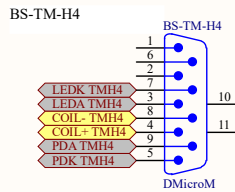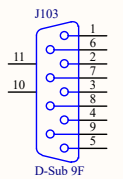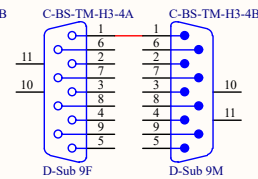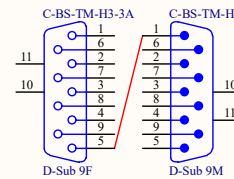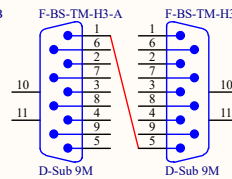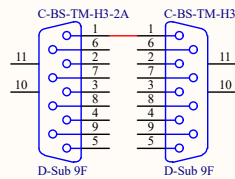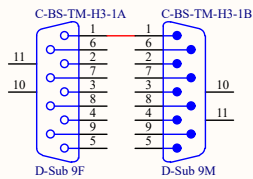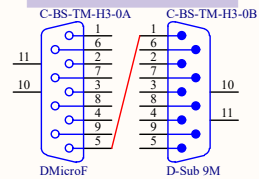

Type 5-2.2 (BS) or -2 (SR)

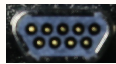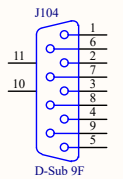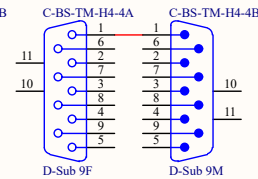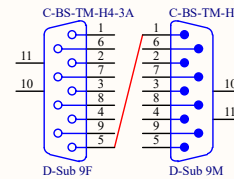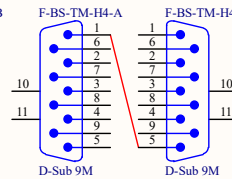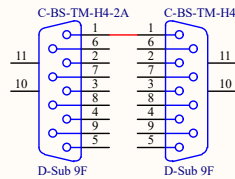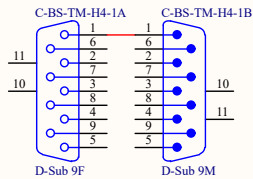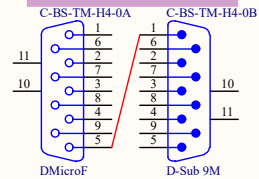

Male



Female

Resistances/voltages at male end of Type 5 OSEM cable:

1/6: PD, 0.466 V

2/7: Coil, 14.5-15.1 Ω

3/8: LED, 0.975 V

The OSEMS on the BS are on the HR side of the optic and the layout looking directly at them is

H4 H1  
H3 H2

The OSEMS on the SR are on the AR side and the layout looking directly at them is

H1 H4  
H2 H3

This was chosen to make the orientation the same when looking towards +L.

In some cases, especially on the BS, the Type 1 cable was replaced by a flipping Female-Female gender changer because there was excess length.

This then required a NON-flipping Anti-Feedthrough Adapter on the outside of the feedthrough.

Each OSEM has a D-Micro male, which looks superficially like it might be female but has pins in recesses. The OSEM and cable were both shown with the wrong gender until ~v13 of this diagram. Note that pins are numbered from top left on male and top right on female.

Type 5 cables have a flip to correct a flexicircuit issue.

The BS Test Hang used full OSEMs with PDs and LEDs at the TM level, but the BS Final Hang and the SRs use coil-only OSEMs.

Title Type B Suspension Cabling - TM OSEMs		
Size A3	Number JGW-D1503600	Revision -v16
Date: 2019/06/16	Sheet 1 of 19	
File: \\.\01 TM OSEMs.SchDoc	Drawn By:	

# 6 Feedthroughs

## IM OSEMs

### OSEM

IM OSEM to BF Cable  
JGW-D1503901 Sheet 02

BF to F0 Signal Cable  
JGW-D1503901 Sheet 08

PI-Flange Signal Cable  
JGW\_D1503901 Sheet 11

### Feedthrough

### Anti-Feedthrough Adapter Cable

### OSEM External Cable

Sat Amp #1  
D1402809

Glennair GMR7590-9P-1BPN  
BS-IM-V1

Glennair MWDMLZ-9SS  
C-BS-IM-V1-0A C-BS-IM-V1-0B

C-BS-IM-V1-1A C-BS-IM-V1-1B
















































C-BS-IM-V1-2A C-BS-IM-V1-2B

F-BS-IM-V1-A F-BS-IM-V1-B

C-BS-IM-V1-3A C-BS-IM-V1-3B

C-BS-IM-V1-4A C-BS-IM-V1-4B

J-BS-SA2-101

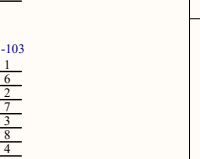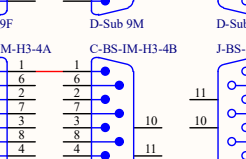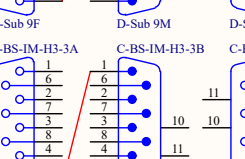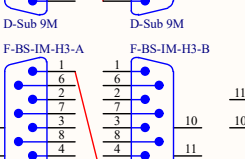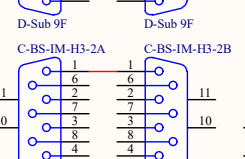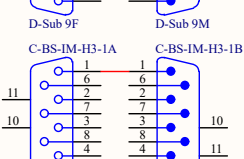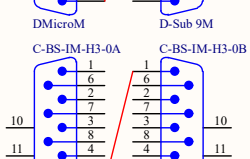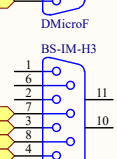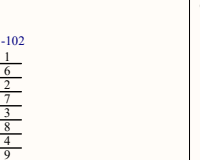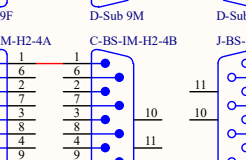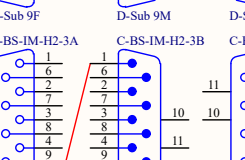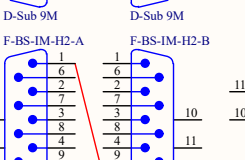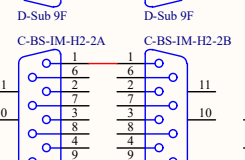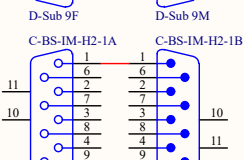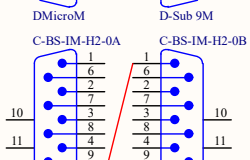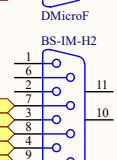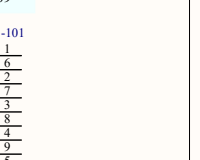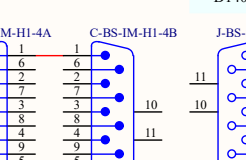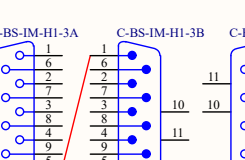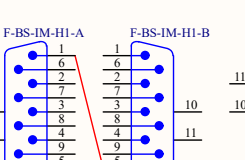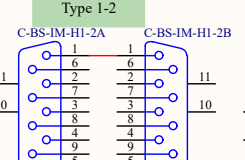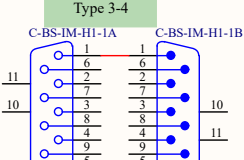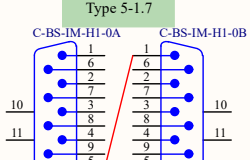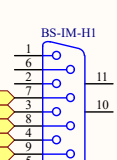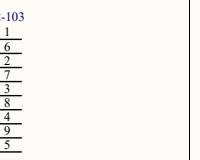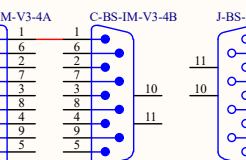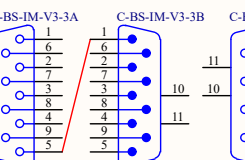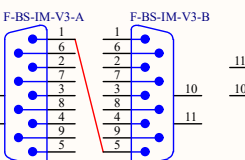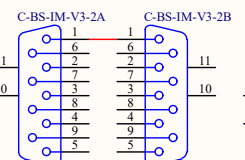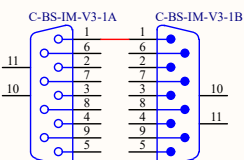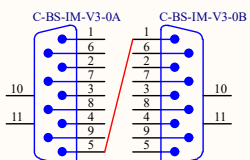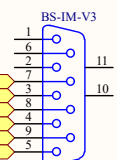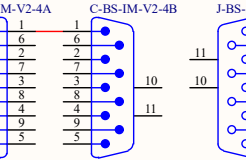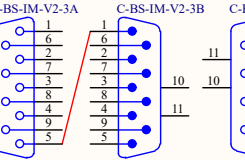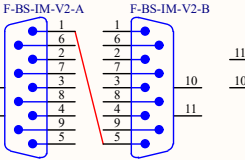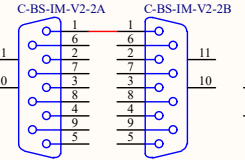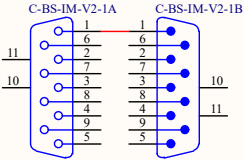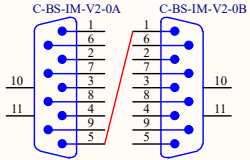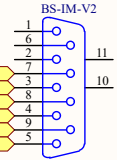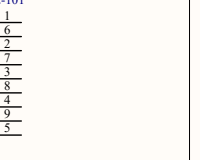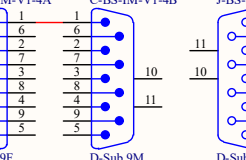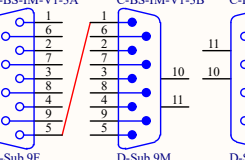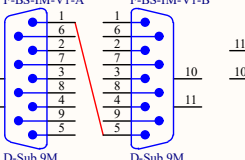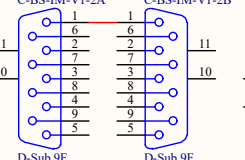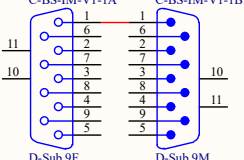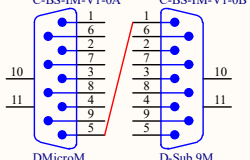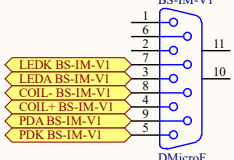

Type 5 cables have a flip to correct flexicircuit issue.

Each OSEM has a D-Micro male, which looks superficially like a female but has pins in recesses. The OSEM and cable were both shown with the wrong gender until -v13 of this diagram

Resistances/voltages at male end of Type 5 OSEM cable:


- 1/6: PD, 0.466 V
- 2/7: Coil, 14.5-15.1  $\Omega$
- 3/8: LED, 0.975 V

J-BS-SA3-103 and J-BS-SA3-104 not used

Title Type B Suspension Cabling - IM OSEMs			
Size A3	Number JGW-D1503600	Revision -v16	
Date: 2019/06/16	Sheet 7 of 19		Drawn By:
File: \\02 IM OSEMs.SchDec			

# 1 Feedthrough

## IM Picomotors & BF Yaw Picomotor

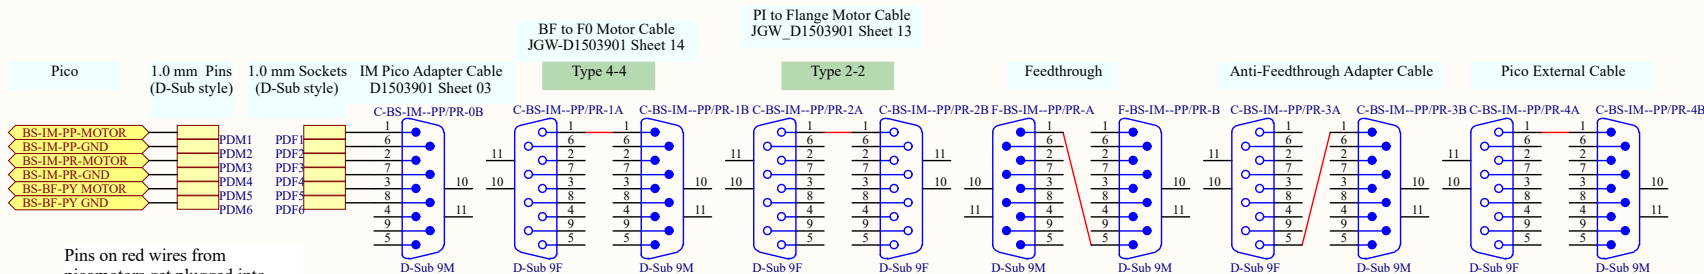

Pins on red wires from picomotors get plugged into sockets from pins 1, 2, 3.

Pins on white wires from picomotors get plugged into sockets from pins 6, 7, 8.

The pico motor at the bottom level of the IM does pitch and gets plugged into 1&6.

The pico motor at the top level of the IM does roll and gets plugged into 2&7.


The pico motor in the BS does IM yaw and gets plugged into 3&8.

The connectors for the pico drivers are RJ22 with four pins. I couldn't find Altium versions, so I used a random four-pin connector.

The adapter cable is made by combining the cables supplied by the pico manufacturer (Newport) with a D-Sub 9 female.

Green wires from manufacturer's cables get soldered to pins 1, 2, 3.

Yellow wires from manufacturer's cables get soldered to pins 6, 7, 8.

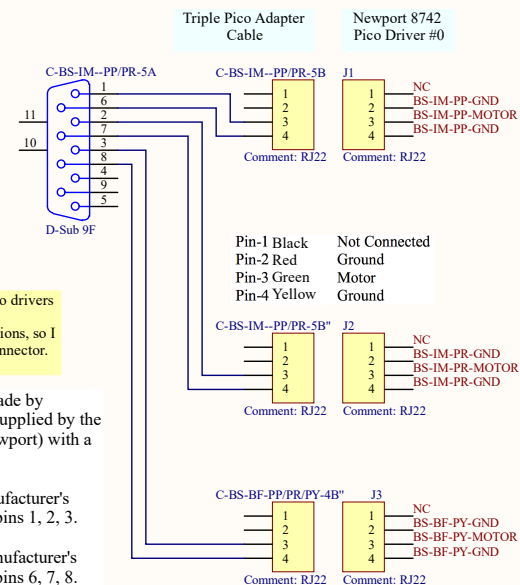

In -v10, the BS Yaw Pico was moved to the IM sheet and grouped with the IM picos, because it's more physically convenient for wiring and more logical (it actually rotates the IM).

Title Type B Suspension Cabling - IM Picos and BF Yaw Pico		
Size A3	Number JGW-D1503600	Revision -v16
Date: 2019/06/16	Sheet 3of 19	
File: \\.\03 IM Picos & BF Yaw Pico.SchDoe	Drawn By:	

### 3 Feedthroughs


In -v10, the BS Yaw Pico was moved to the IM sheet and grouped with the IM picos, because it's more physically convenient for wiring and more logical (it actually rotates the IM).

## BF and F1 Picomotors and Steppers

The connectors for the pico drivers are RJ22 with four pins. I couldn't find Altium versions, so I used a random four-pin connector.

Pin-1 Black Ground  
Pin-2 Red Motor  
Pin-3 Green Ground  
Pin-4 Yellow Ground

Newport 8742 Pico Driver #1

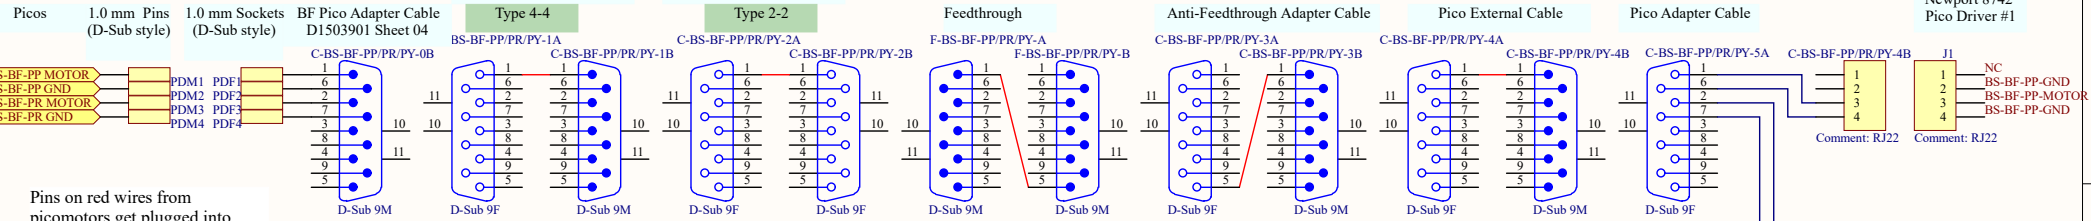



Pins on red wires from picomotors get plugged into sockets from pins 1, 2.

Pins on white wires from picomotors get plugged into sockets from pins 6, 7.



The adapter cable is made by combining the cables supplied by the pico manufacturer (Newport) with a D-Sub 9 female.

Green wires from manufacturer's cables get soldered to pins 1, 2.

Yellow wires from manufacturer's cables get soldered to pins 6, 7.

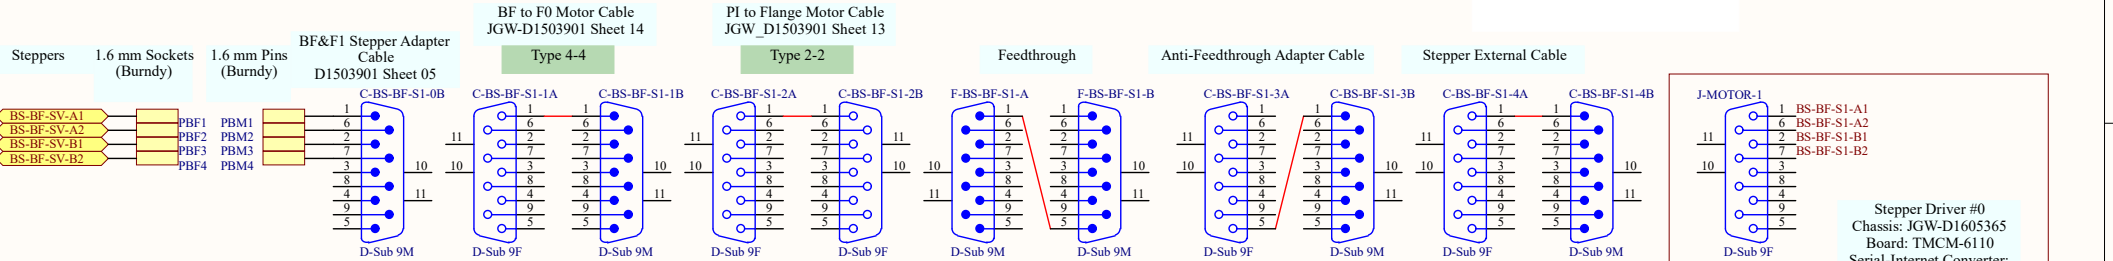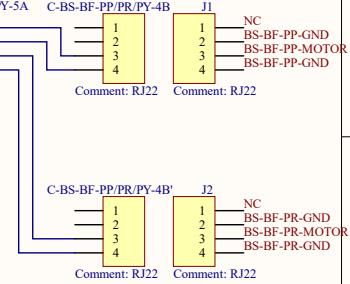

Stepper Driver #0  
Chassis: JGW-D1605365  
Board: TMCM-6110  
Serial-Internet Converter: MOXA NPort 5100A

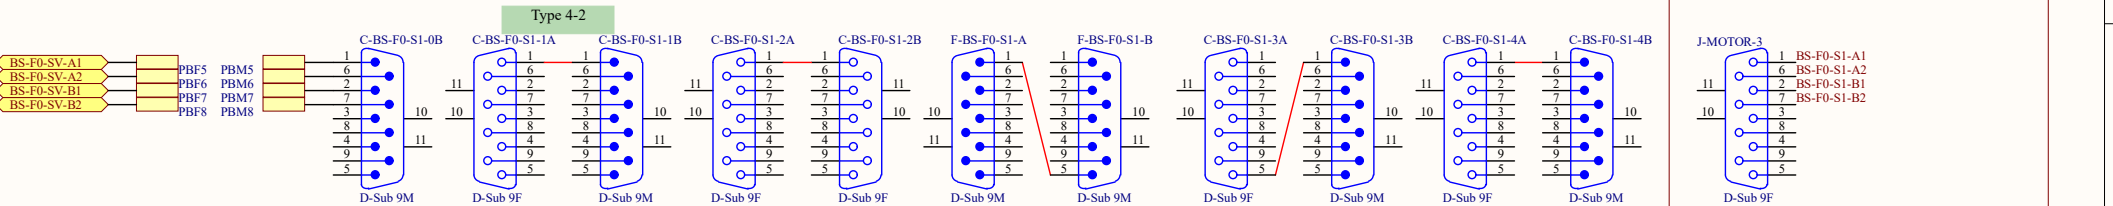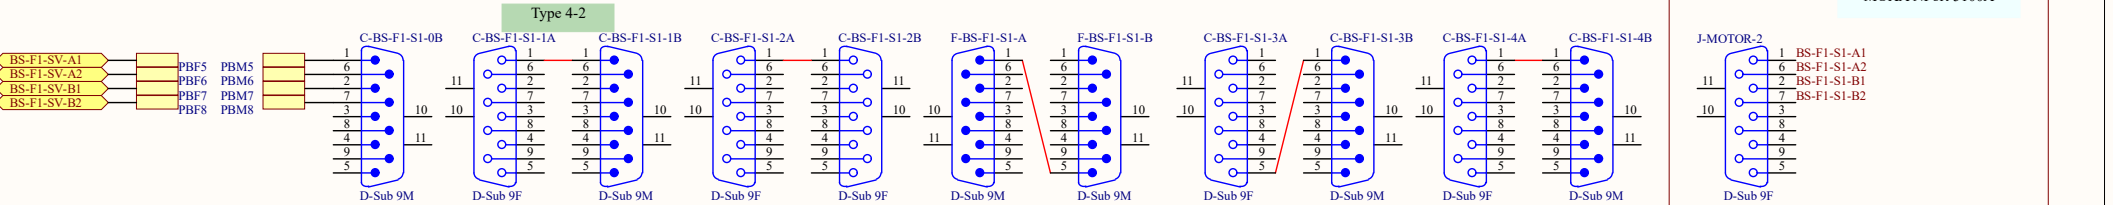

	Colour
Phase A+	Green
Phase A-	Grey
Phase B+	Black
Phase B-	White
Thermocouple +	Brown
Thermocouple -	Blue

Coil resistances (including one "Type 3" cable):

SV: 5.5 Ω

-v16: For the first time, the stepper motor channel assignments correctly reflect the as-built default. HOWEVER, in several cases stepper driver channels have failed and stepper motors have had to be reassigned. See <http://gwwiki.icrr.u-tokyo.ac.jp/JGW/wiki/KAGRA/Subgroups/DGS/Projects/StepperMotor> for the latest news.


Title		
Type B Suspension Cabling - Bottom and Standard Filter Picos/Steppers		
Size A3	Number JGW-D1503600	Revision -v16
Date: 2019/06/16	Sheet 4of 19	
File: \\04 BF&F1 Picos&Steppers.SchDoc	Drawn By:	

# GAS (BF, F1 and F0) LVDT/ACTs

## 2 Feedthroughs


LVDT/Act  
BF GAS

BS-BF-LV

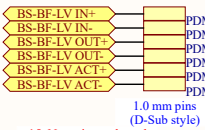

1.0 mm pins  
(D-Sub style)  
-v15: Note size and gender  
change - 1.6 mm sockets to  
1.0 mm pins


BF&F1 LVDT Adapter Cable  
JGW-D1503901 Sheet 06

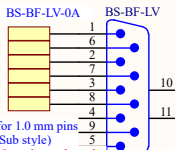

Sockets for 1.0 mm pins  
(D-Sub style)  
-v15: Note size and gender  
change - 1.6 mm pins to  
1.0 mm sockets

BF-PI Signal Cable  
JGW-D1503901 Sheet 08


Type 3-4

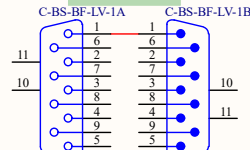

D-Sub 9F D-Sub 9M


PI-Flange Signal Cable  
JGW\_D1503901 Sheet 11

Type 1-2

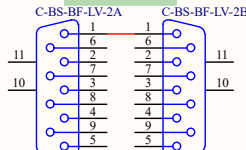


D-Sub 9F D-Sub 9F

Feedthrough

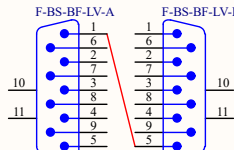


D-Sub 9M D-Sub 9M

Feedthrough Adapter Cable

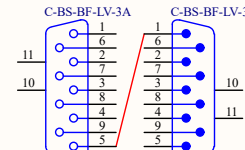

D-Sub 9F D-Sub 9M


External Cable

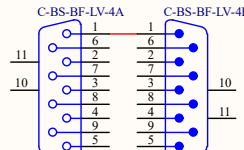

D-Sub 9F D-Sub 9M

LVDT/ACT Distributor - see also Sheet 12  
Chassis: JGW-D1402124  
Front Panel: JGW-D1402827  
Rear Panel: JGW-D1402828  
Board: JGW-D1402117


Ch 0

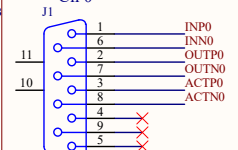

D-Sub 9F


LVDT/Act  
F1 GAS

BS-F1-LV

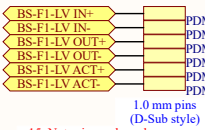

1.0 mm pins  
(D-Sub style)  
-v15: Note size and gender  
change - 1.6 mm sockets to  
1.0 mm pins


BF&F1 LVDT Adapter Cable  
JGW-D1503901 Sheet 06

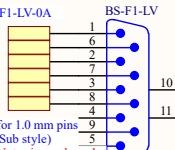

Sockets for 1.0 mm pins  
(D-Sub style)  
-v15: Note size and gender  
change - 1.6 mm pins to  
1.0 mm sockets

BF-PI Signal Cable  
JGW-D1503901 Sheet 08


Type 3-2

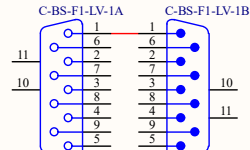

D-Sub 9F D-Sub 9M


PI-Flange Signal Cable  
JGW\_D1503901 Sheet 13

Type 1-2

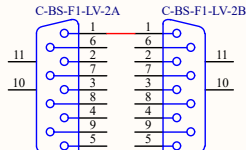


D-Sub 9F D-Sub 9F

Feedthrough

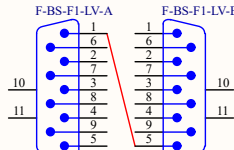


D-Sub 9M D-Sub 9M

Feedthrough Adapter Cable

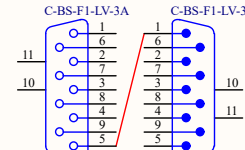


D-Sub 9F D-Sub 9M

External Cable

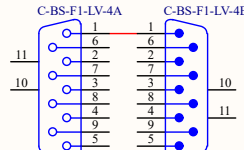

D-Sub 9F D-Sub 9M


Ch 1

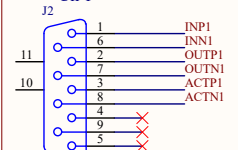

D-Sub 9F

LVDT/Act  
F0 GAS


BS-F0-LV

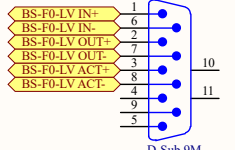


D-Sub 9M

OPTIONAL  
Signal Cable Extension  
JGW\_D1503901 Sheet 10


Type 1-2

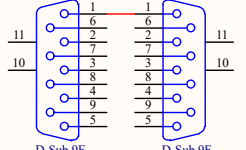


D-Sub 9F D-Sub 9F

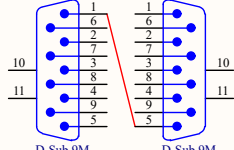

D-Sub 9M D-Sub 9M

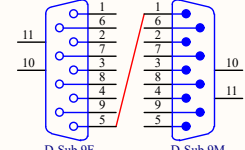


D-Sub 9F D-Sub 9M

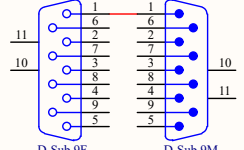

D-Sub 9F D-Sub 9M


(Unused)

Ch 2

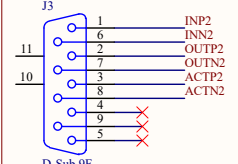

D-Sub 9F

Ch 3

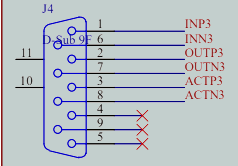

D-Sub 9F

"IN" = 1/6 = Primary = Single Coil = AWG36, 187Ω, 38 mH

"OUT" = 2/7 = Secondary = Double Coil = AWG32, 78Ω, 9.5 mH

"ACT" = 3/8 = Force Coil = AWG32, 110Ω, 74 mH




Title Type B Suspension Cabling - GAS LVDTs		
Size A3	Number JGW-D1503600	Revision -v16
Date: 2019/06/16	Sheet 5of 19	Drawn By:
File: \\.\05 GASLVDTs.SchDoc		

# 4 Feedthroughs

# IP LVDTs

## LVDT/ACT

OPTIONAL  
Signal Cable Extension  
JGW\_D1503901 Sheet 10

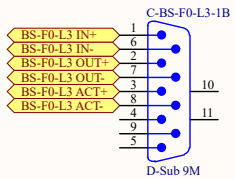
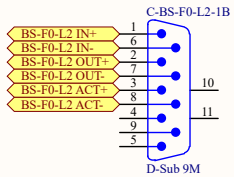
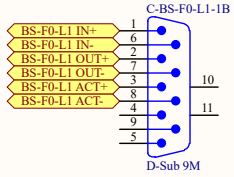


## LVDT-COIL




Pin	Function
1	LVDT IN P
2	LVDT OUT P
3	COIL P
4	
5	
6	LVDT IN N
7	LVDT OUT N
8	COIL N
9	

## PI-Flange Signal Cable JGW\_D1503901 Sheet 11




### Type 1-2

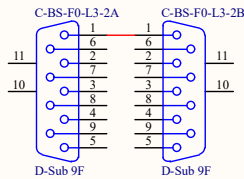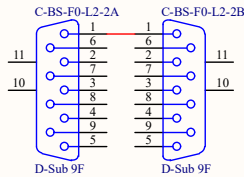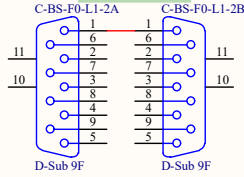




## Feedthrough

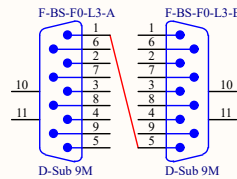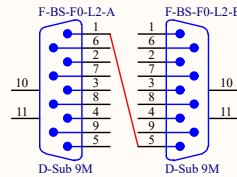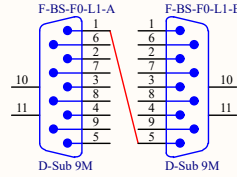

## Anti-Feedthrough Adapter Cable

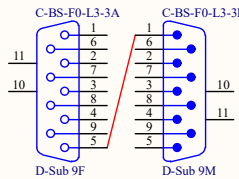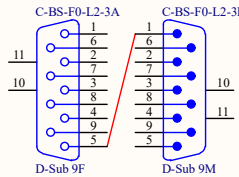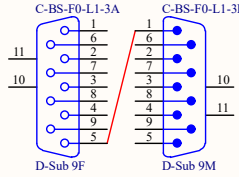


## LVDT/ACT External Cable

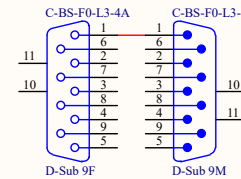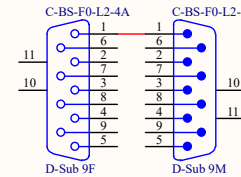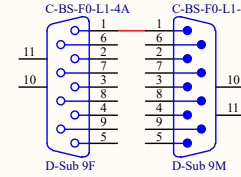


LVDT/ACT Distributor - see also Sheet 13  
Chassis: JGW-D1402124  
Front Panel: JGW-D1402827  
Rear Panel: JGW-D1402828  
Board: JGW-D1402117


### Ch 4

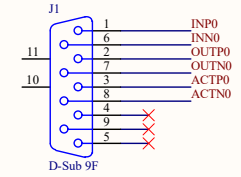


### Ch 5

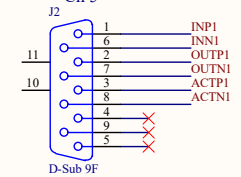

### Ch 6

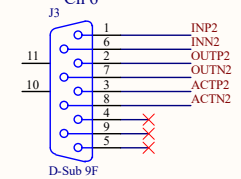

### Ch 7

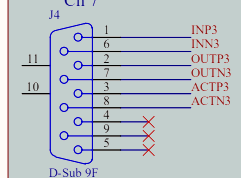

## Coil resistances:

"IN" = 1/6 = Primary = Single Coil = 250 Ω

"OUT" = 2/7 = Secondary = Double Coil = 320 Ω

"ACT" = 3/8 = Force Coil = 155 Ω

**BS Currently has Primaries and Secondaries swapped, 2017-05-30**

Title			
Type B Suspension Cabling - IP LVDTs			
Size	Number	Revision	
A3	JGW-D1503600	-v16	
Date:	2019/06/16	Sheet 6of 19	
File:	\\06 IPLVDTs.SchDoc	Drawn By:	

# 4 Feedthroughs

The vertical and yaw steppers have no limit switches and are combined on a single cable that VIS needs to provide.

# Preisolator Steppers

TMCM-6110  
Stepper Driver #2

Stepper Splitter Cable  
Double Motor Version





Stepper Driver #1  
Chassis: JGW-D1605365  
Board: TMCM-6110  
Serial-Internet Converter:  
MOXA NPort 5100A

Stepper

F0 Stepper Adapter  
JGW-D1503901 Sheet 24

-v16: The horizontal stepper limit switches indicated were never implemented and have been removed.

























Pin	Function
1	COIL A P
2	COIL B P
3	Switch 1 P
4	Switch 2 P
5	
6	COIL A N
7	COIL B N
8	Switch 1 N
9	Switch 2 N

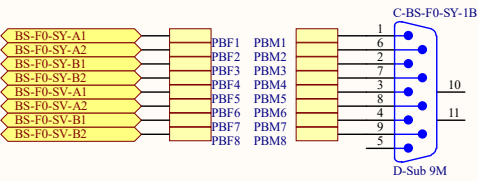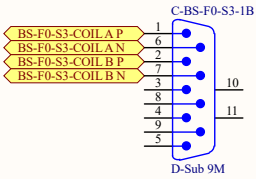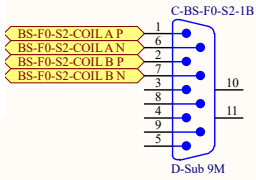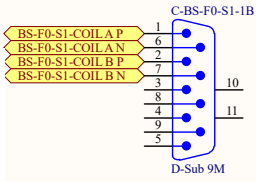











OPTIONAL  
Motor Cable Extension  
JGW\_D1503901 Sheet 16

PI to Flange Motor Cable  
JGW-D1503901 Sheet 13

Type 2-2

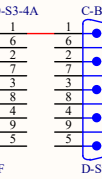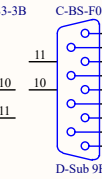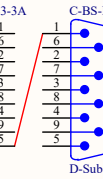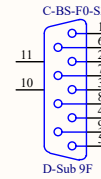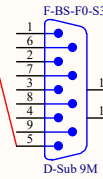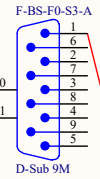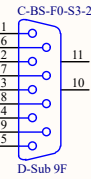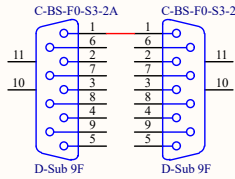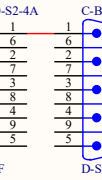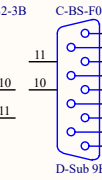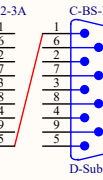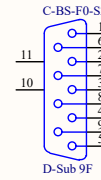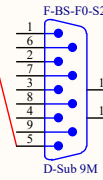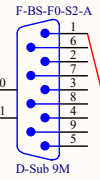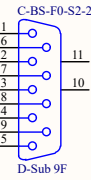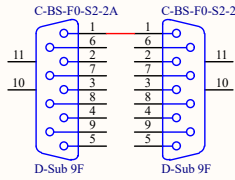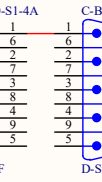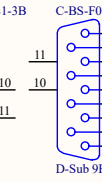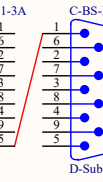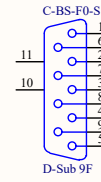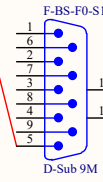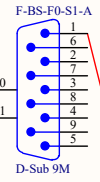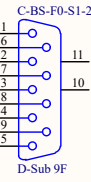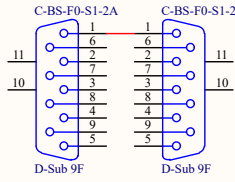

PI to Flange Motor Cable  
JGW-D1503901 Sheet 13

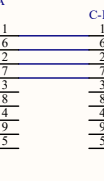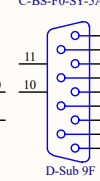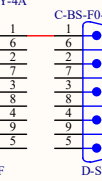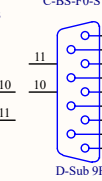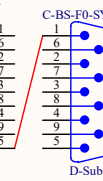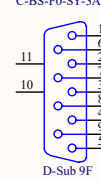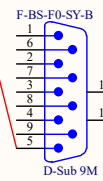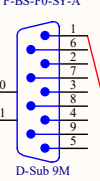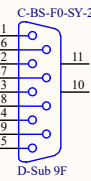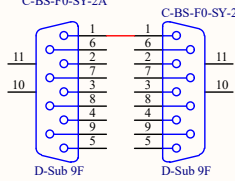







Coil resistances (including one "Type 3" cable):

S1/S2/S3: 6.8-7.2 Ω

SV: 5.5 Ω

SY: 5.2 Ω

-v16: For the first time, the stepper motor channel assignments correctly reflect the as-built default. HOWEVER, in several cases stepper driver channels have failed and stepper motors have had to be reassigned. See <http://gwwiki.icrr.u-tokyo.ac.jp/JGWwiki/KAGRA/Subgroups/DGS/Projects/StepperMotor> for the latest news.

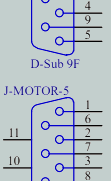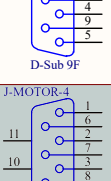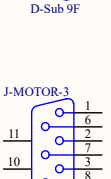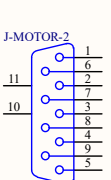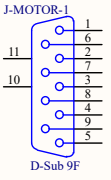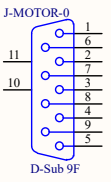

Title		
Type B Suspension Cabling - Preisolator Steppers		
Size	Number	Revision
A3	JGW-D1503600	-v16
Date:	2019/06/16	Sheet 7of 19
File:	\\.\07.PI Steppers.SchDoc	Drawn By:



# 3 Feedthroughs

# Preisolator Geophones

Geophone Pod Internal Cabling  
(same for all three pods):

Pod #1: geophone L400002322, preamp 15  
Pod #2: geophone L400002321, preamp 12  
Pod #3: geophone L400002323, preamp 14



## Geophone Pod

Geophone Adapter Cable  
JGW-D1503901 Sheet 07

PI to Flange Geophone Cable  
JGW-E1503901 Sheet 11




## Feedthrough

## Anti-Feedthrough Adapter Cable

## Geophone External Cable

## Geophone Unscrambler Cable

Geophone Distributor  
JGW-D1402120

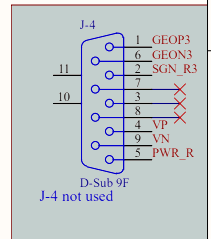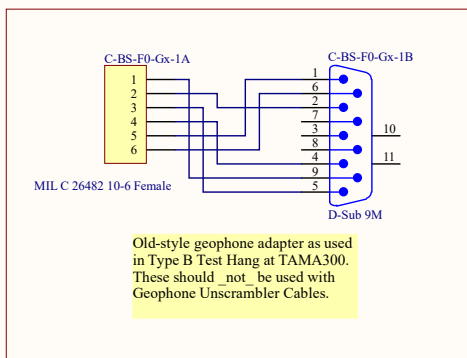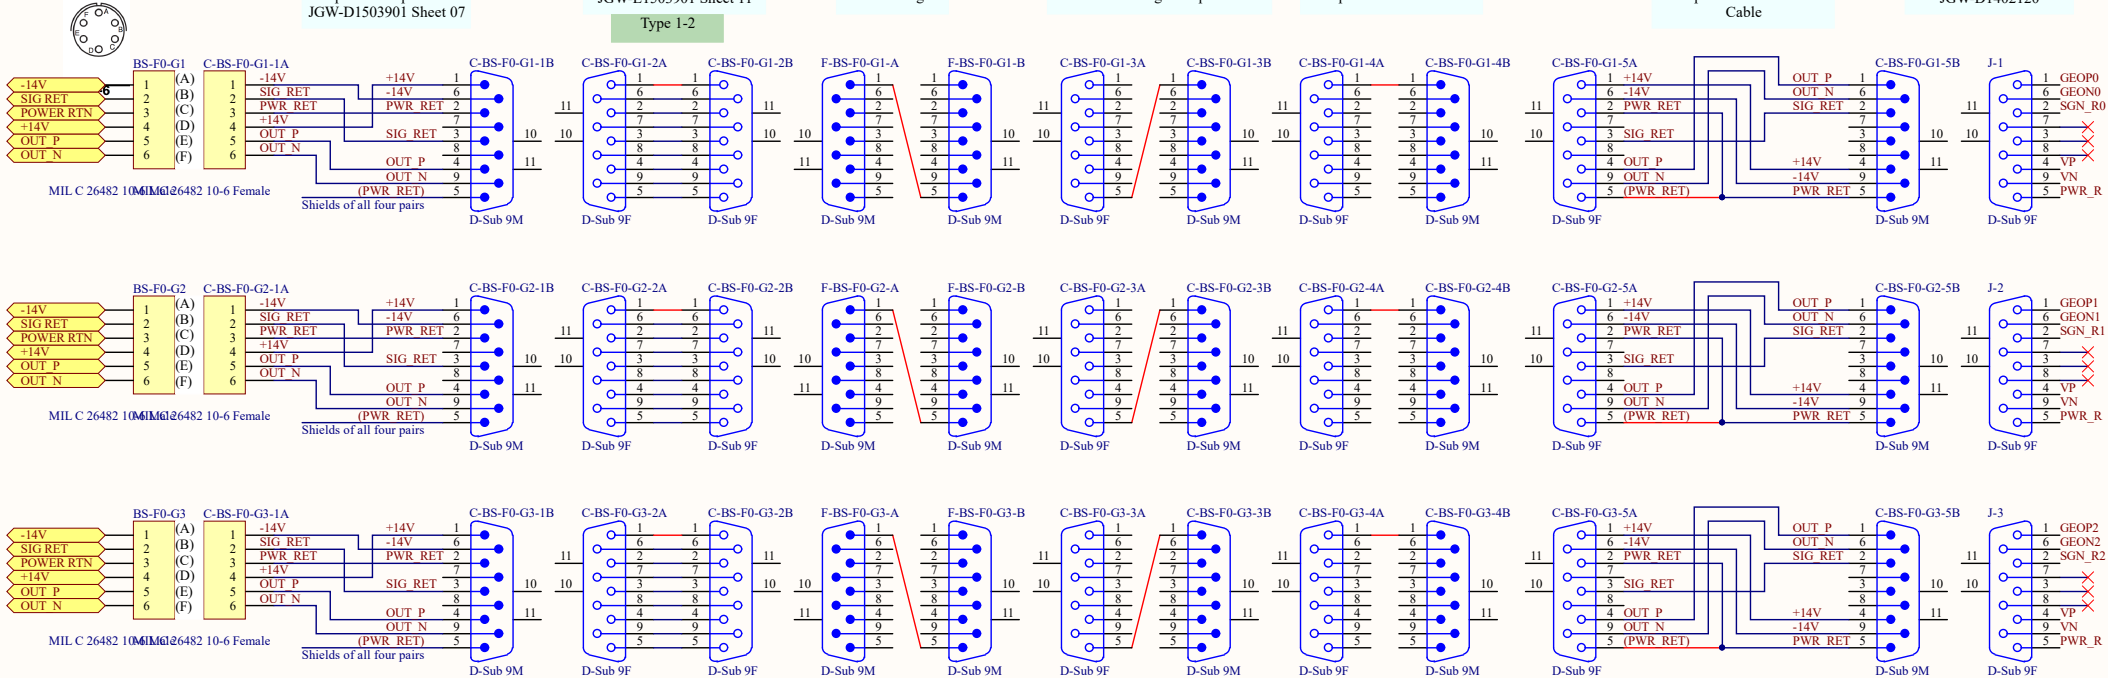

Title Type B Suspension Cabling - Preisolator Geophones		
Size A3	Number JGW-D1503600	Revision -v16
Date: 2019/06/16	Sheet 8 of 19	Drawn By:
File: \\08 PI Geophones.SchDoc		








# TM OSEM Sat Amp and Coil Driver

The original design called for low power coil drivers for the TM and IM OSEMs and the names of the boxes used here reflect this. The current baseline is TM=LPCD, IM-H=MPCD and IM-V=HPCD.


## Sat Amp #0

Chassis: JGW-D1503498,  
Front Panel: JGW-D1503500,  
Rear Panel: JGW-D1503500,  
Board: JGW-D1503499


Inputs from TM OSEMs (see Sheet 1)

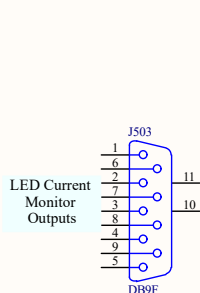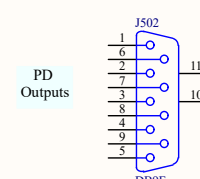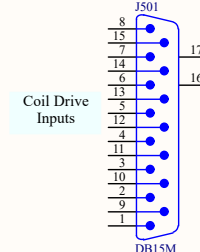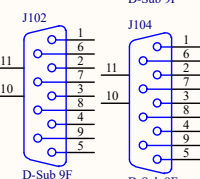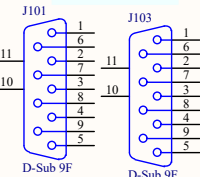


## AI Chassis #0 D1100650

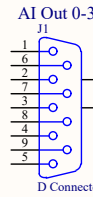






## Generic D-Sub 9 Cable M-F

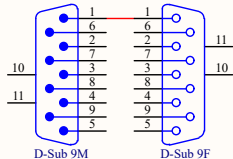

## Generic D-Sub 15 Cable M-F

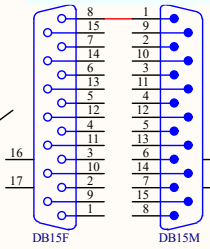


## AA Chassis #1 D1100621

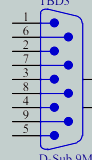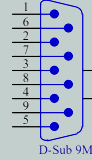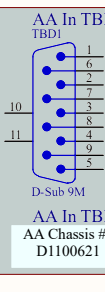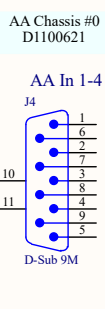
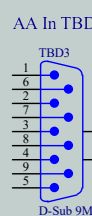


## Low Power Coil Driver #0


### Coil Current Request Inputs

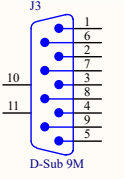



### Coil Drive Outputs

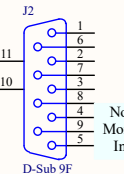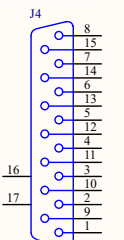


### Voltage Monitor Outputs

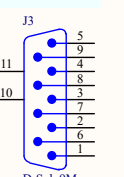


### Fast Current Monitor Outputs

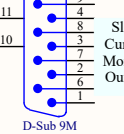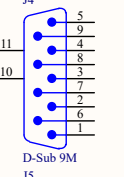

### Binary IO 2 DIO Input

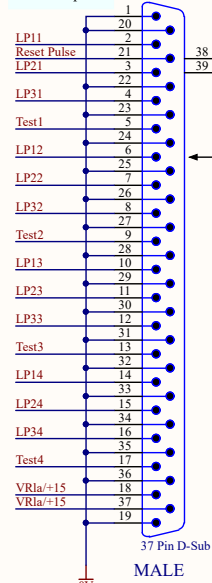


### Binary IO 1 DIO Output

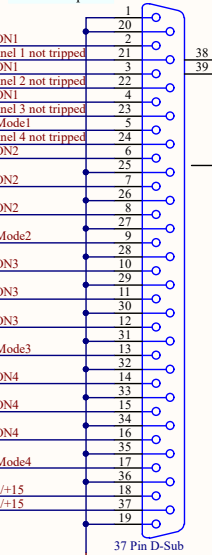


Chassis: JGW-D1503506,  
Front Panel: JGW-D1503508,  
Main Board: JGW-D1503507  
BIO Board: JGW-D1504332

## Cable F-m and Gender Bender F-F 37 pin

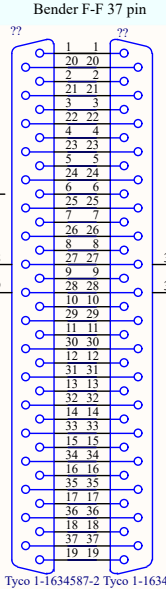


## Cable M-F 37 pin


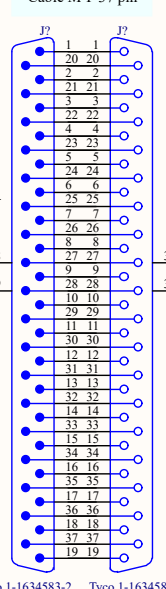


## DIO Card #0

Contec DIO-6464L-PE

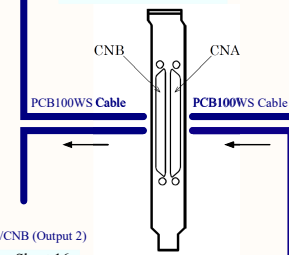

CNB/CNB (Output 2) See Sheet 16.

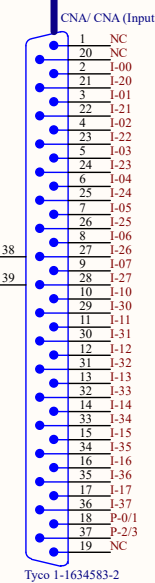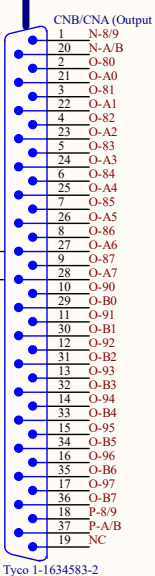

Title		
Type B Suspension Cabling - TM OSEM Sat Amp & Coil Driver		
Size	Number	Revision
A3	JGW-D1503600	-v16
Date:	2019/06/16	Sheet 9 of 19
File:	\\09 TM Sat Amp & Coil Driver.SchDoc	
Drawn By:		






# IM Vertical OSEM Sat Amp and Coil Driver

The original design called for low power coil drivers for the TM and IM OSEMs and the names of the boxes used here reflect this. The current baseline is TM=LPCD, IM-H=MPCD and IM-V=HPCD.


## Sat Amp #1

Chassis: JGW-D1503498,  
Front Panel: JGW-D1503500,  
Rear Panel: JGW-D1503500,  
Board: JGW-D1503499


Inputs from IM OSEMs  
V1, V2, V3  
(see Sheet 2)

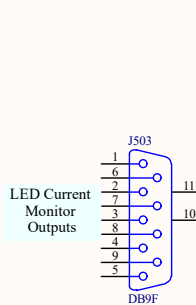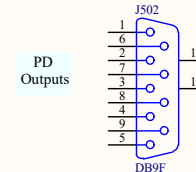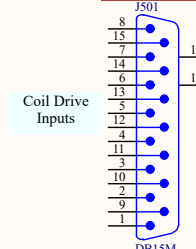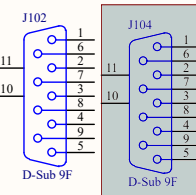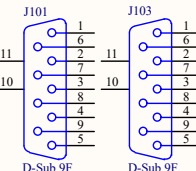


AI Chassis #0  
D1100650

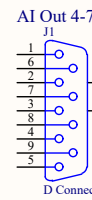


Generic D-Sub 9 Cable M-F

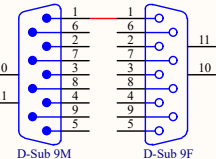


Generic D-Sub 15 Cable M-F

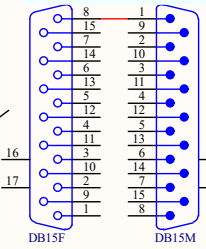


Generic D-Sub 9 Cable M-F

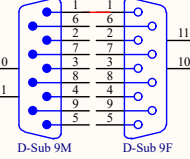


AA Chassis #0  
D1100621

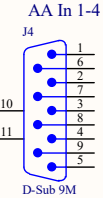


Generic D-Sub 9 Cable M-F

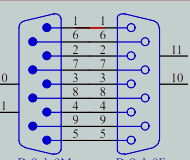


AA In TBD  
TBD1

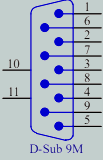


AA Chassis #1  
D1100621

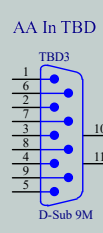


Generic D-Sub 9 Cable M-F

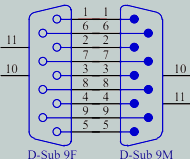


AA In TBD  
TBD2

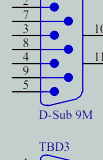


Generic D-Sub 9 Cable M-F

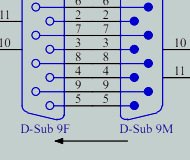

AA In TBD  
TBD3

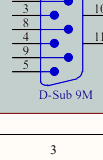


Generic D-Sub 9 Cable M-F


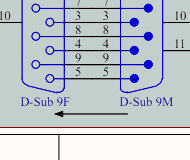


## Low Power Coil Driver #1


Coil Current Request Inputs

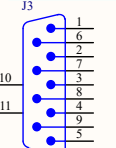



Coil Drive Outputs

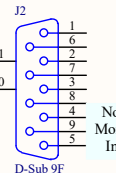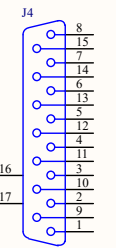


Voltage Monitor Outputs

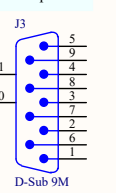


Fast Current Monitor Outputs

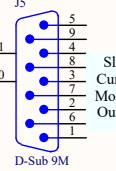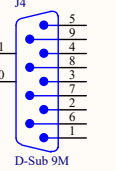

Binary IO 2  
DIO Input

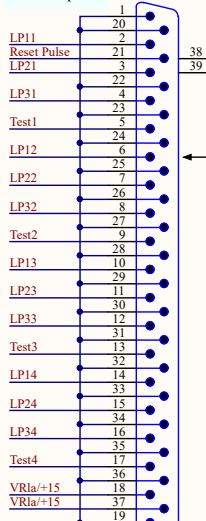


Binary IO 1  
DIO Output

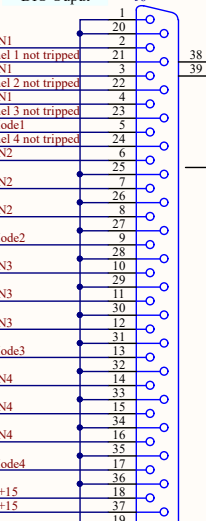


Chassis: JGW-D1503506,  
Front Panel: JGW-D1503508,  
Main Board: JGW-D1503507  
BIO Board: JGW-D1504332


Cable F-M and Gender  
Bender F-F 37 pin

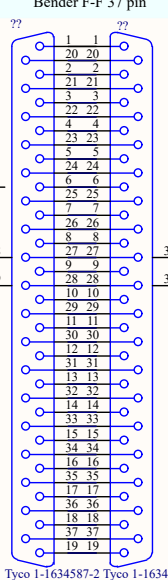


Cable M-F 37 pin

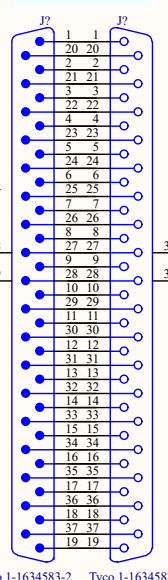

CNB/CNA (Output 1)

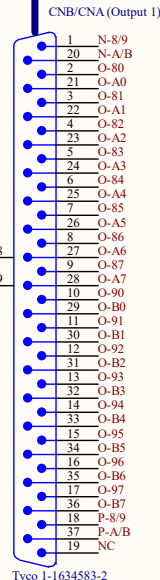


CNA/CNA (Input 1)

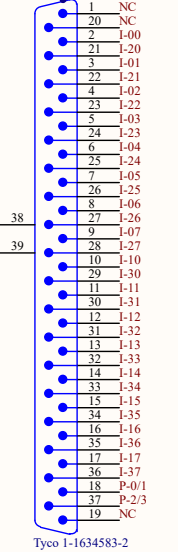

## DIO Card #1

Contec DIO-6464L-PE

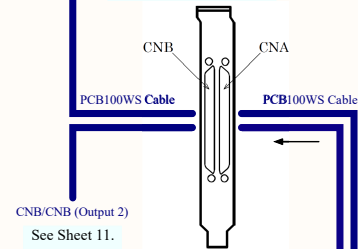

CNB/CNB (Output 2)  
See Sheet 11.

CNA/CNA (Input 2)  
See Sheet 11.

Title  
Type B Suspension Cabling - IM-V OSEM Sat Amp & Coil Driver





Size A3 Number JGW-D1503600 Revision -v16

Date: 2019/06/16 Sheet10of 19

File: \\U10-IM-V Sat Amp & Coil Driver Sch... Drawn By:

# IM Horizontal OSEM Sat Amp and Coil Driver

The original design called for low power coil drivers for the TM and IM OSEMs and the names of the boxes used here reflect this. The current baseline is TM=LPCD, IM-H=MPCD and IM-V=HPCD.





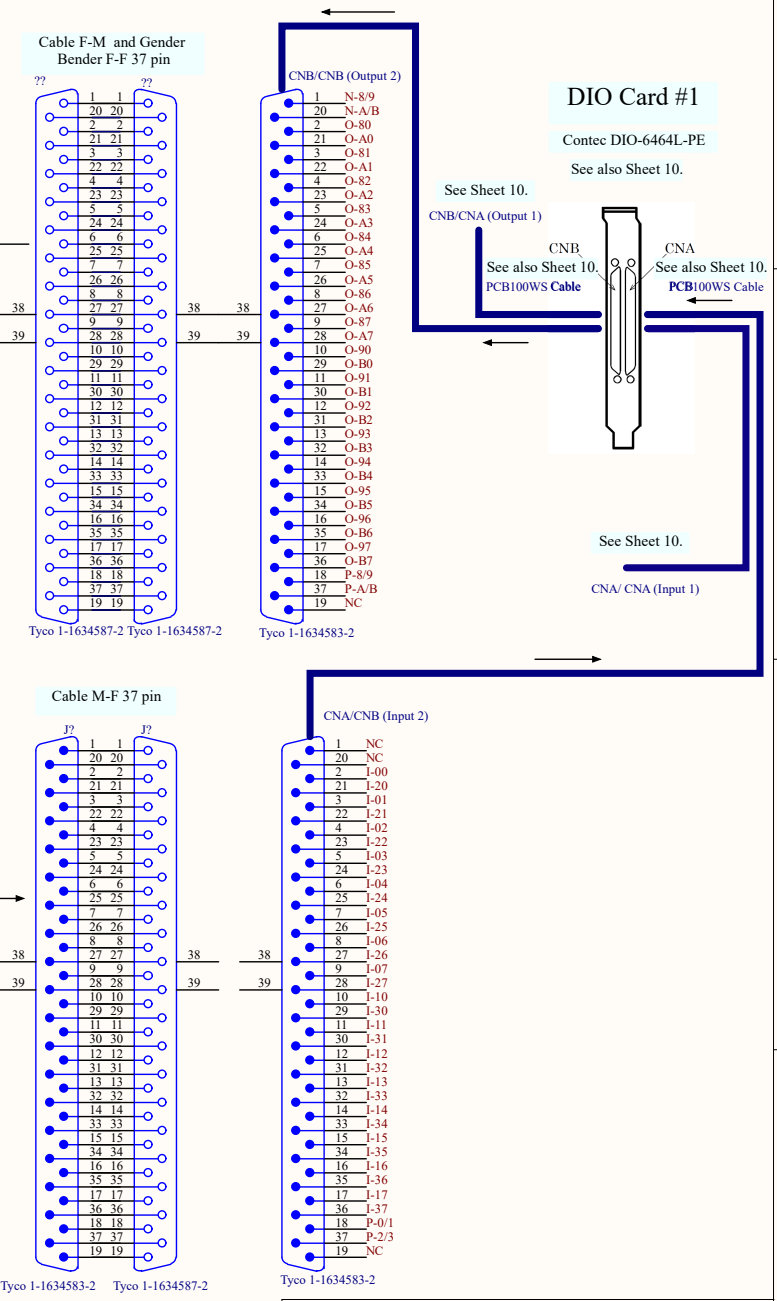
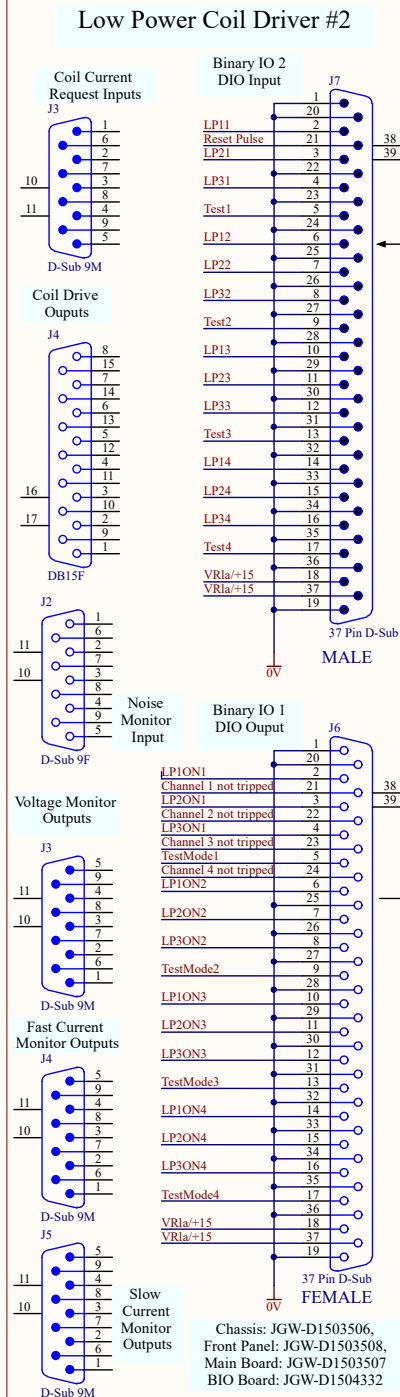
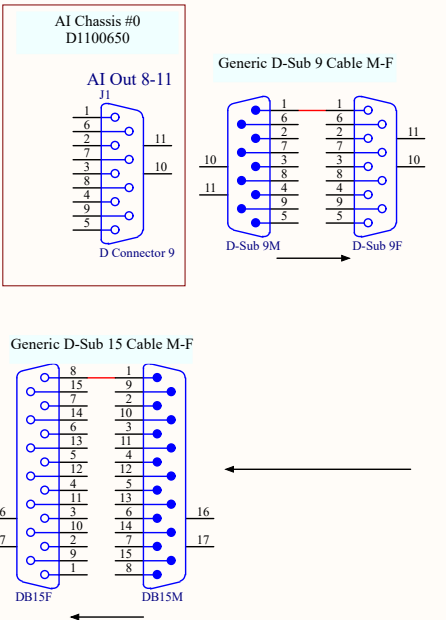
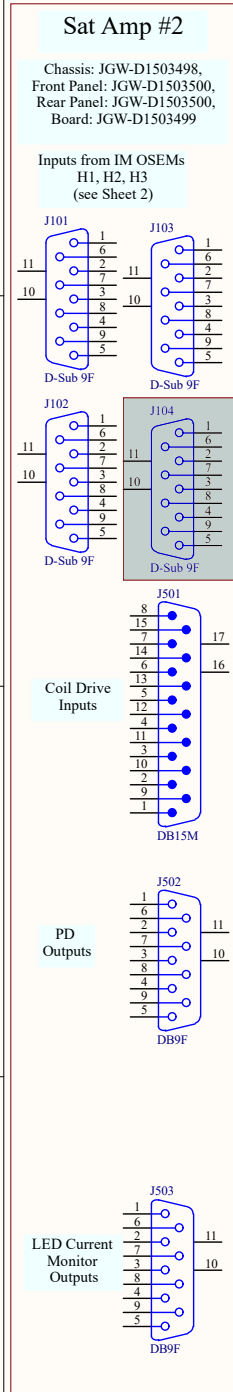


Title		
Type B Suspension Cabling - IM-V OSEM Sat Amp & Coil Driver		
Size	Number	Revision
A3	JGW-D1503600	-v16
Date:	2019/06/16	Sheet 1 of 19
File:	\\M1-IM-H Sat Amp & Coil Driver Sch... Drawn By:	


# GAS LVDT Driver Readout

## Inputs from GAS LVDTs (see Sheet 5)

LVDT/ACT Distributor - see also Sheet 13  
 Chassis: JGW-D1402124  
 Front Panel: JGW-D1402827  
 Rear Panel: JGW-D1402828  
 Board: JGW-D1402117

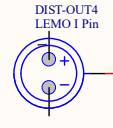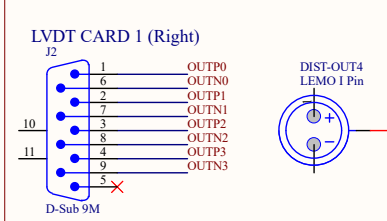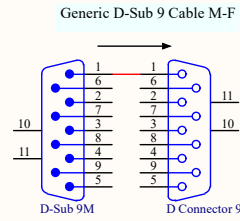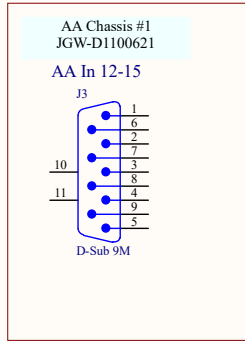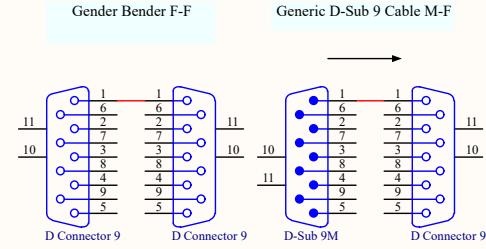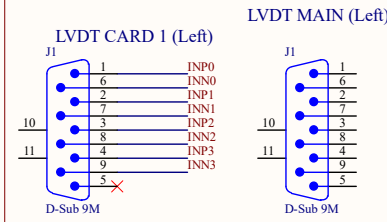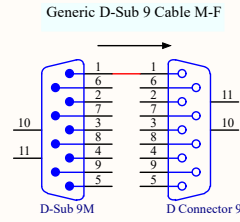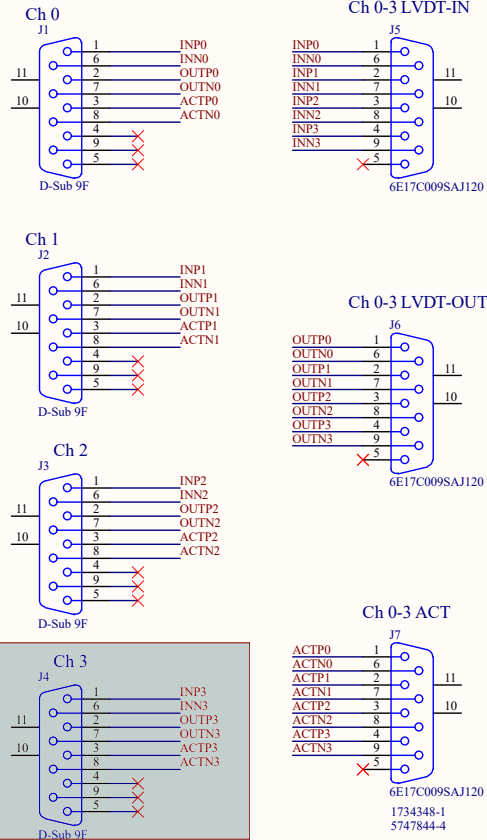

The LVDT Chassis has provision for an oscillator card, but until such time as the cards are available, an external oscillator will be required

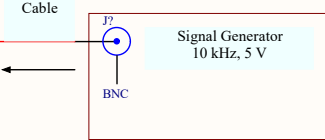


See sheet 13.

Title			Type B Suspension Cabling - GAS LVDT Driver Readout		
Size	Number	Revision			
A3	JGW-D1503600	12	-v16		
Date:	2019/06/16	Sheet		of 19	
File:	\\112 GASLVDT Drive Readout.SchDoc				
		Drawn By:			


# GAS LVDT Driver Actuation/BIO

## Inputs from GAS LVDTs (see Sheet 5)



LVDT/ACT Distributor - see also Sheet 13  
 Chassis: JGW-D1402124  
 Front Panel: JGW-D1402827  
 Rear Panel: JGW-D1402828  
 Board: JGW-D1402117

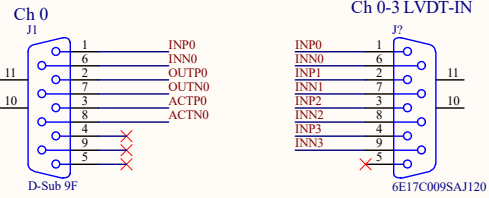

See sheet 12.

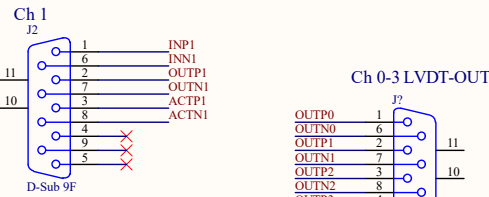


See sheet 12.

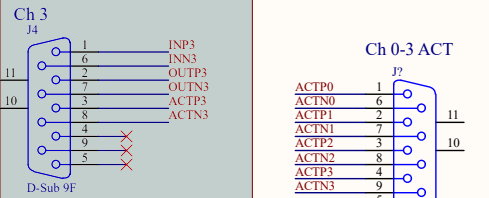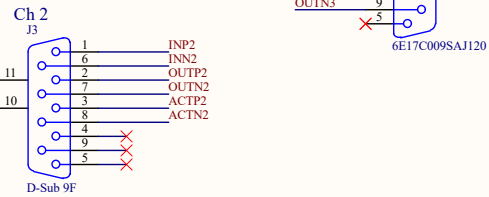


AI Chassis #1  
D1101521


AI Out 1-4

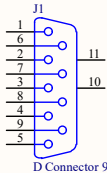



LVDT-Coil Driver Cable

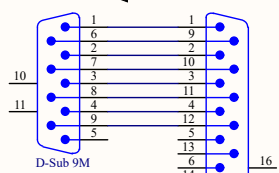

Generic D-Sub 9 Cable M-F

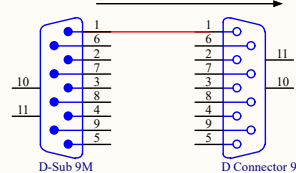


## High Power Coil Driver #1

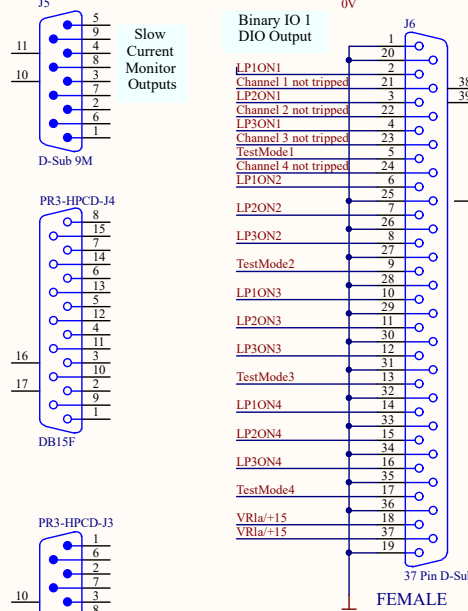
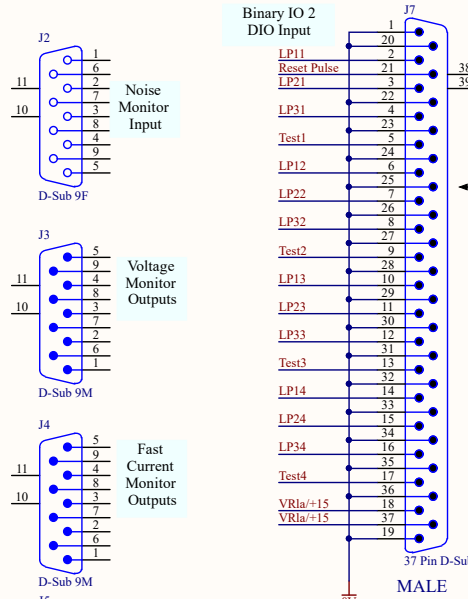


High Power Coil Driver #1  
 Chassis: JGW-D1503504  
 Front Panel: JGW-D1503502  
 Rear Panel: JGW-D1503505,  
 Monitor Board: JGW-D1503510  
 Coil Driver Interface Board: JGW-D1504332  
 Main Board: JGW-D1503503

Cable F-M and Gender Bender F-F 37 pin

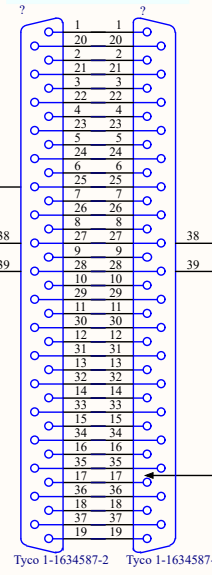

Cable M-F 37 pin

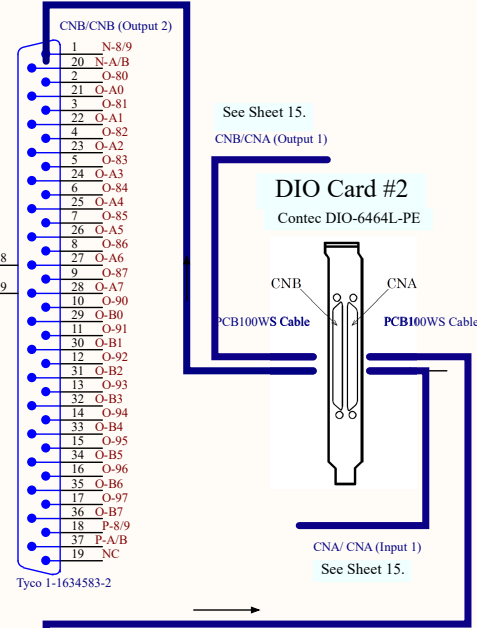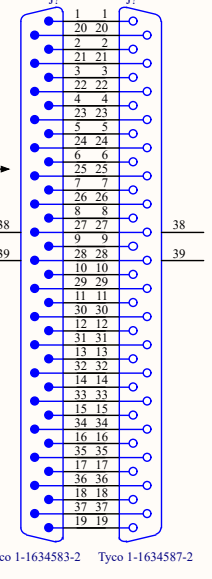

See Sheet 15.

See Sheet 15.

The ports on the back of the BIO card are called CNA and CNB in teh Contec documentation, and the two arms of the PCB100WS splitter cable are \_also\_ called CNA and CNB!

Here, CNA/CNB means the CNA port and the CNB cable.








Title Type B Suspension Cabling - GAS LVDT Driver Actuation/BIO			
Size A3	Number JGW-D1503600	Revision 13	Sheet of 19
Date: 2019/06/16	File: \\A13 GASLVDT Drive Act&BIO.Sch		Drawn By: 19

**Inputs from F0  
LVDTs  
(see Sheet 6)**

(LVDT/ACT Distributor - see Sheet 12)  
Chassis: JGW-D1402124,  
Front Panel: JGW-D1402827  
Rear Panel: JGW-D1402828,  
Board: JGW-D1402117 #1

Front Panel


Rear Panel

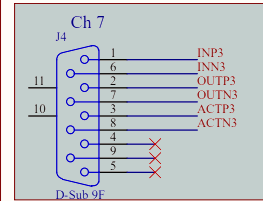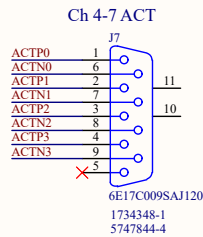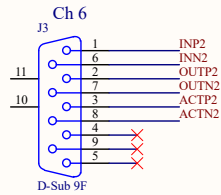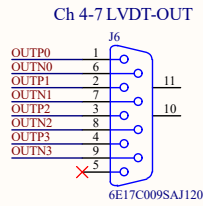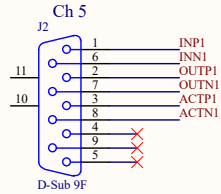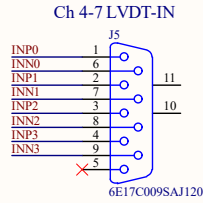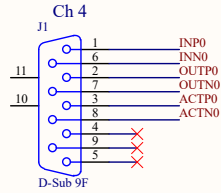


**IP LVDT Driver Readout**

(LVDT Driver - see Sheet 12)  
Chassis: JGW-D1402826,  
Main Board: JGW-D1301467  
Input Boards (2): JGW-D1301467  
Front Panel: JGW-D1402827


Generic D-Sub 9 Cable M-F

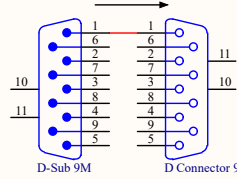


LVDT MAIN (Right)

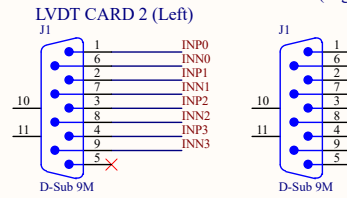


Generic D-Sub 9 Cable M-F

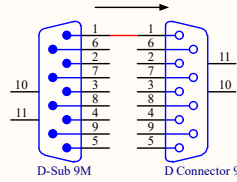


LVDT CARD 2 (Right)

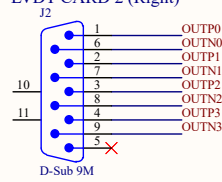

Gender Bender F-F

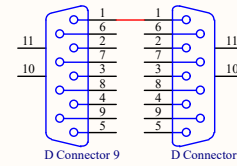


Generic D-Sub 9 Cable M-F

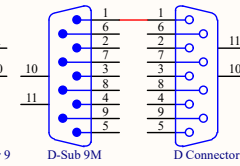

AA Chassis #1  
JGW-D1100621

AA In 16-20

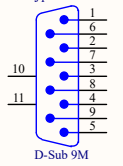


See sheet 15.

Title Type B Suspension Cabling - IP LVDT Driver Readout			
Size A3	Number JGW-D1503600	Revision 14 -v16	Sheet of 19
Date: 2019/06/16	File: \\14 IPLVDT Drive Readout.SchDoc		Drawn By:



**Inputs from IP LVDTs (see Sheet 6)**


(LVDT/ACT Distributor - see Sheet 12)  
 Chassis: JGW-D1402124,  
 Front Panel: JGW-D1402827  
 Rear Panel: JGW-D1402828,  
 Board: JGW-D1402117 #1

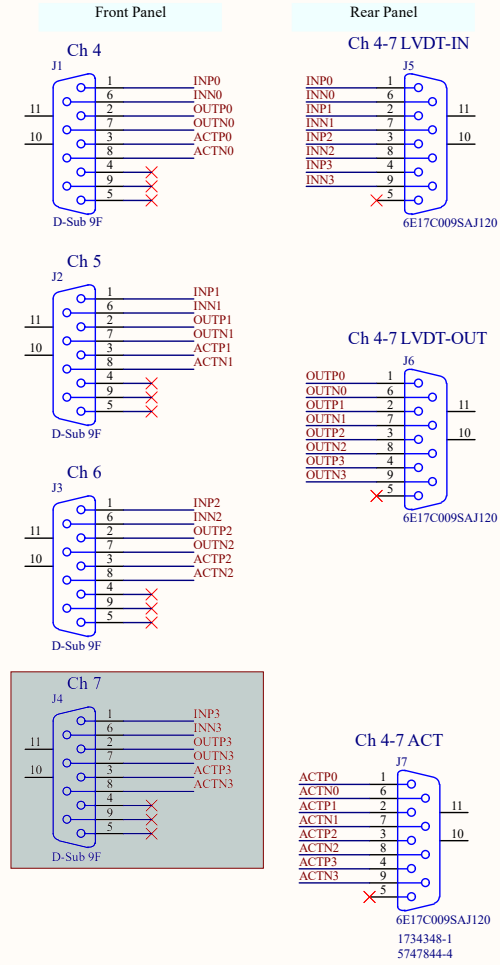


See sheet 14.

See sheet 14.

LVDT-Coil Driver Cable

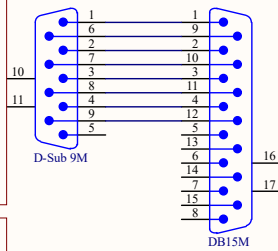


Generic D-Sub 9 Cable M-F

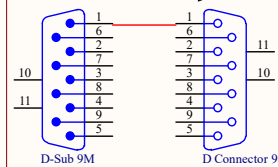


**IP LVDT Driver Actuation/BIO**



**High Power Coil Driver #0**

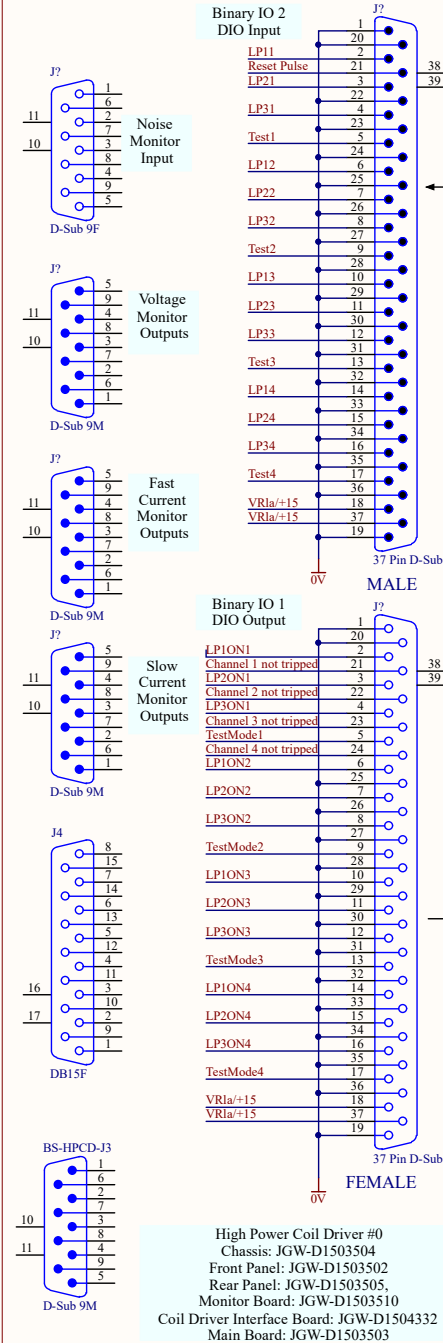

**Cable F-M and Gender Bender F-F 37 pin**

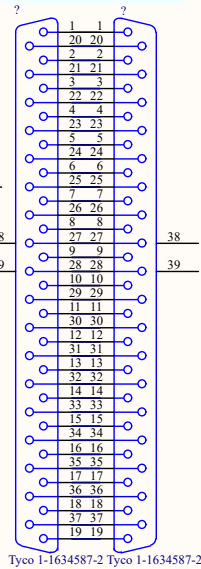

**Cable M-F 37 pin**

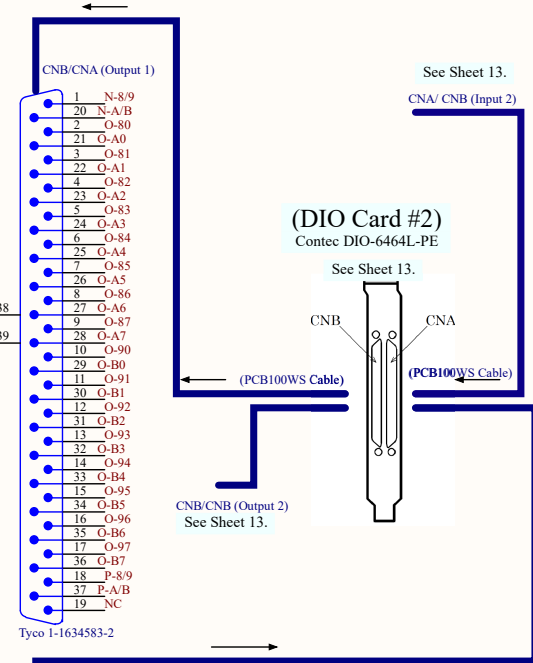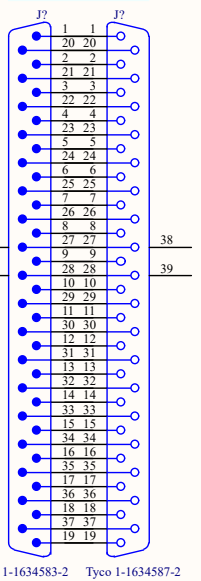

Title		
Type B Suspension Cabling - IP LVDT Driver Actuation/BIO		
Size	Number	Revision
A3	JGW-D1503600	-v16
Date:	2019/06/16	Sheet of 19
File:	\\15 IPLVDT Drive Act&BIO.SchDoc	Drawn By:






# Pico and Stepper Drivers

-v16: For the first time, the stepper motor channel assignments correctly reflect the as-built default. HOWEVER, in several cases stepper driver channels have failed and stepper motors have had to be reassigned. See <http://gwwiki.icrr.u-tokyo.ac.jp/JGWwiki/KAGRA/Subgroups/DGS/Projects/StepperMotor> for the latest news.

Stepper Driver #1  
 Chassis: JGW-D1605365  
 Board: TCMC-6110  
 Serial: MOXA NPort 5100A


-v16: stepper limit switch connections previously shown here were never implemented and have been removed.

Outputs to IM Picos (see Sheet 3)

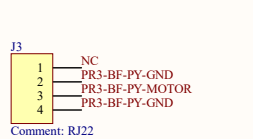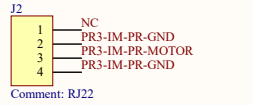
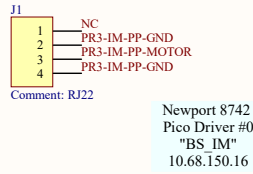


AC

The connectors for the pico drivers are RJ22 with four pins. I couldn't find Altium versions, so I used a random four-pin connector.


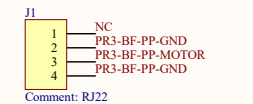


Outputs to BF Picos (see Sheet 4)

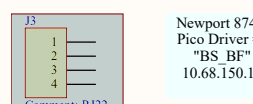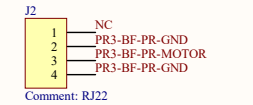

AC

Outputs to BF and F1 GAS Steppers (see Sheet 4) and F0 GAS stepper (see sheet 7).

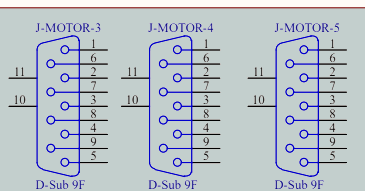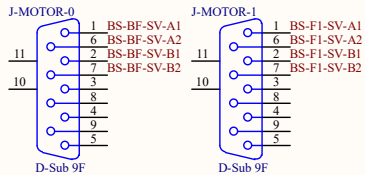

Stepper Driver #0:  
 Chassis: JGW-D1605365  
 Board: Newport TCMC-6110  
 Serial: MOXA NPort 5100A

# Pico and Stepper Drivers

LAN Cable

LAN Cable

LAN Cable

PoE

LAN Cable

LAN Cable

DIO Card #0

See Sheet 9.

Contec DIO-6464L-PE

CNB/CNA (Output 1)

CNA/CNB (Input 2)


PCB100WS Cable

CNA/CNA (Input 2)

See Sheet 9.

CNB/CNB (Output 2)

Cable M-F 37 pin

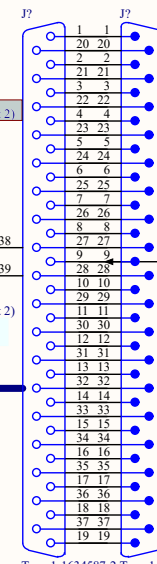







Tyco 1-1634587-2 Tyco 1-1634583-2 Tyco 1-1634587-2

BIO Adapter





JGW-D1605239



Outputs to IP and F0 Yaw Steppers (see Sheet 7)

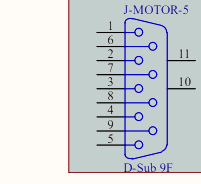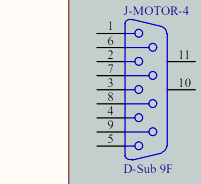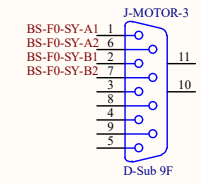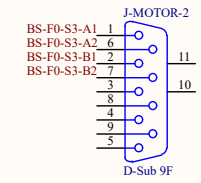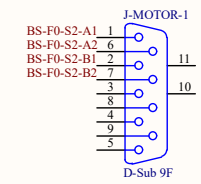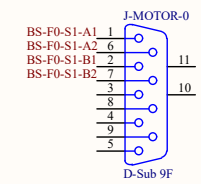

Outputs to Watchdog (see Sheet 19)

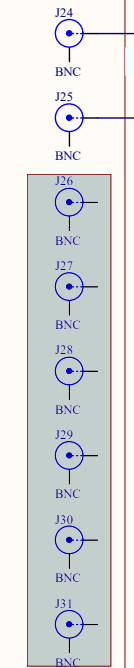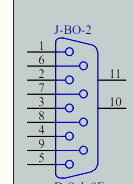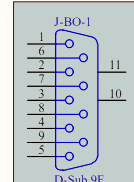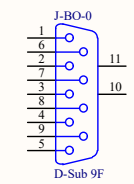

Title		
Type B Suspension Cabling - Pico and Stepper Drivers		
Size	Number	Revision
A3	JGW-D1503600	-v16
Date:	2019/06/16	Sheet of 19
File:	\\16 Pico&Stepper Drive.SchDoc	Drawn By:



3 Feedthroughs

## Geophone Readout


### Inputs from F0 Geophones (see Sheet 8)

Geophone Distributor  
D1402120  
Front Panel  
D1402122  
Board  
D1402121

Geophone Distributor  
D1402120  
Rear Panel  
D1402123  
Board  
D1402121



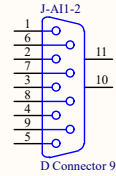
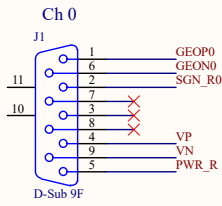


### Generic D-Sub 9 Cable M-F

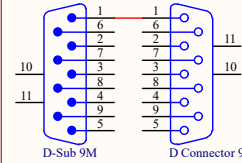

AA Chassis #0  
JGW-D1100621


### AA In 21-24

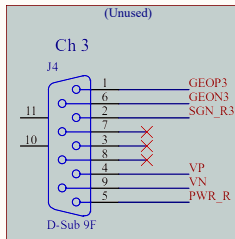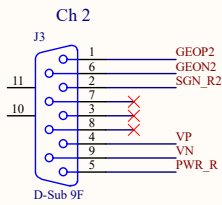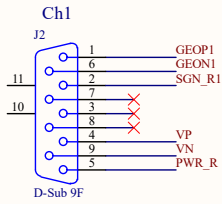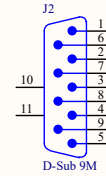



Title Type B Suspension Cabling - Geophone Readout		
Size A3	Number JGW-D1503600	Revision -v16
Date: 2019/06/16	Sheet 17	of 19
File: \\.\17 Geophone Readout.SchDoc		Drawn By:

# OpLev Etc



-v15: OutConfigBoards added by Izumi-san-tachi, klog 4879, 2018-04-28

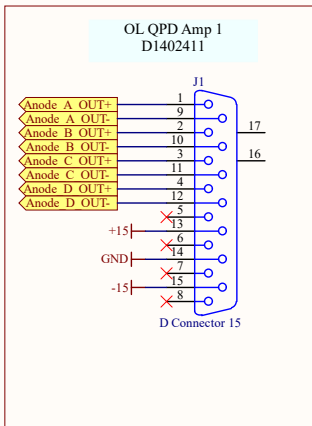

Generic D-Sub 15 Cable M-F

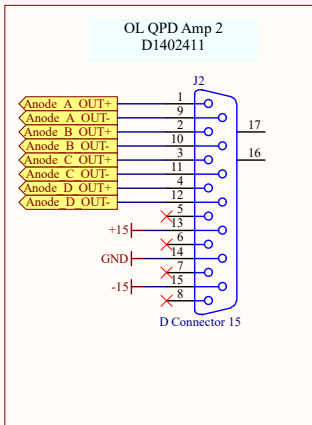
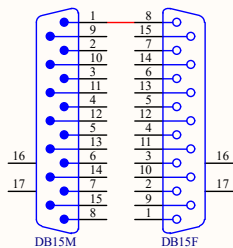


Generic D-Sub 15 Cable M-F



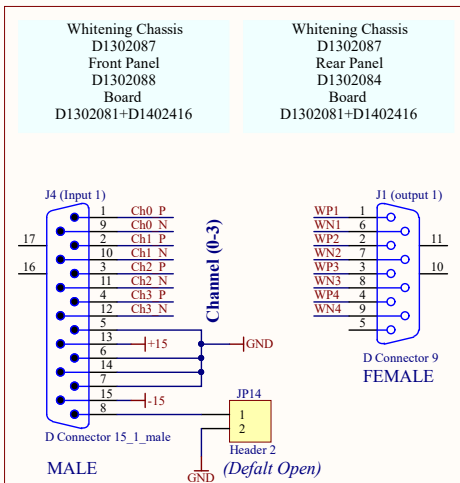
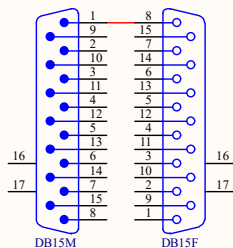


**Whitening Chassis**  
D1302087  
Rear Panel  
D1302084  
Board  
D1302081+D1402416

Generic D-Sub 9 Cable M-F

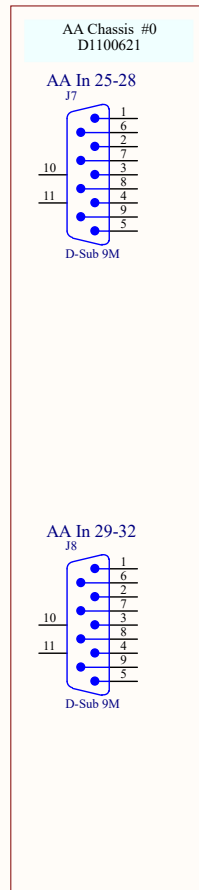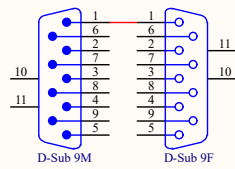


Generic D-Sub 9 Cable M-F

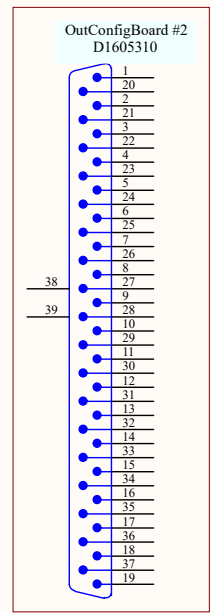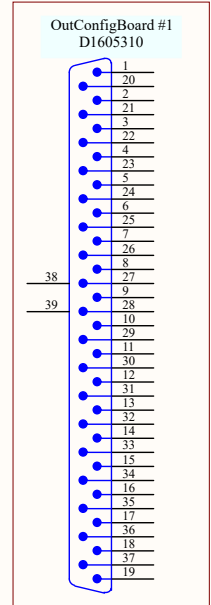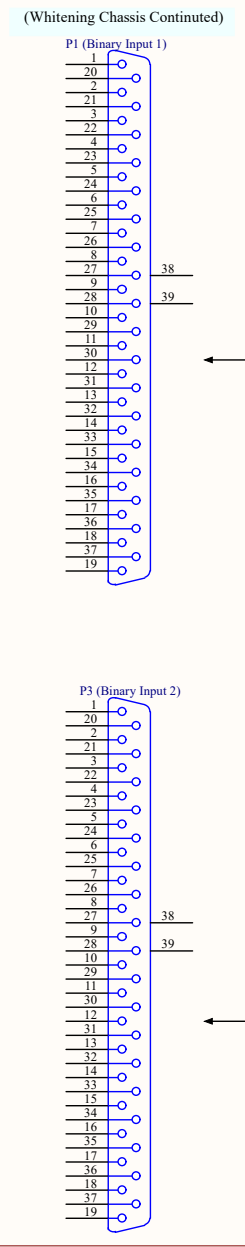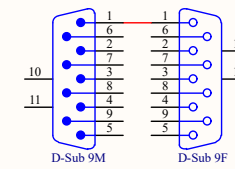


Title			Type B Suspension Cabling - OpLev Etc		
Size	Number	Revision			
A3	JGW-D1503600	19	-v16		
Date:	2019/06/16	Sheet of		19	
File:	\\18 OpLev Etc.SchDoc	Drawn By:			

# Watchdog

Inputs from BIO (see Sheet 16)

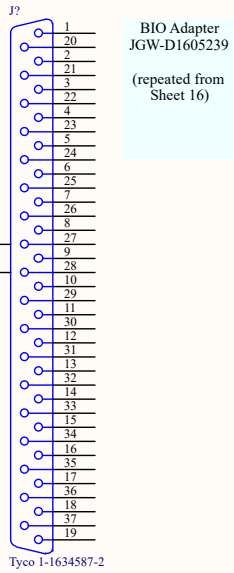

Outputs to Stepper Reset (see Sheet 16)

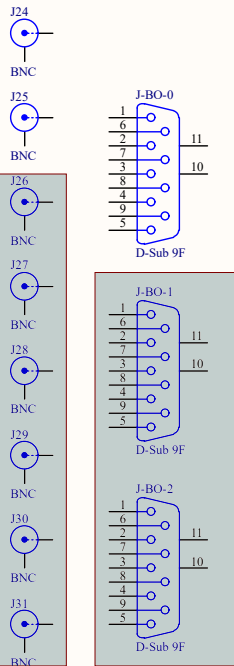

Add Watchdog Stuff Here!

Title Type B Suspension Cabling - Watchdog			
Size A3	Number JGW-D1503600	Revision -v16	Sheet 19
Date: 2019/06/16	File: \\.\19 Watchdog.SchDoc		Drawn By: